


# DRAWING NOTES

Please note: These drawings are for planning purposes only and should not be used for construction.

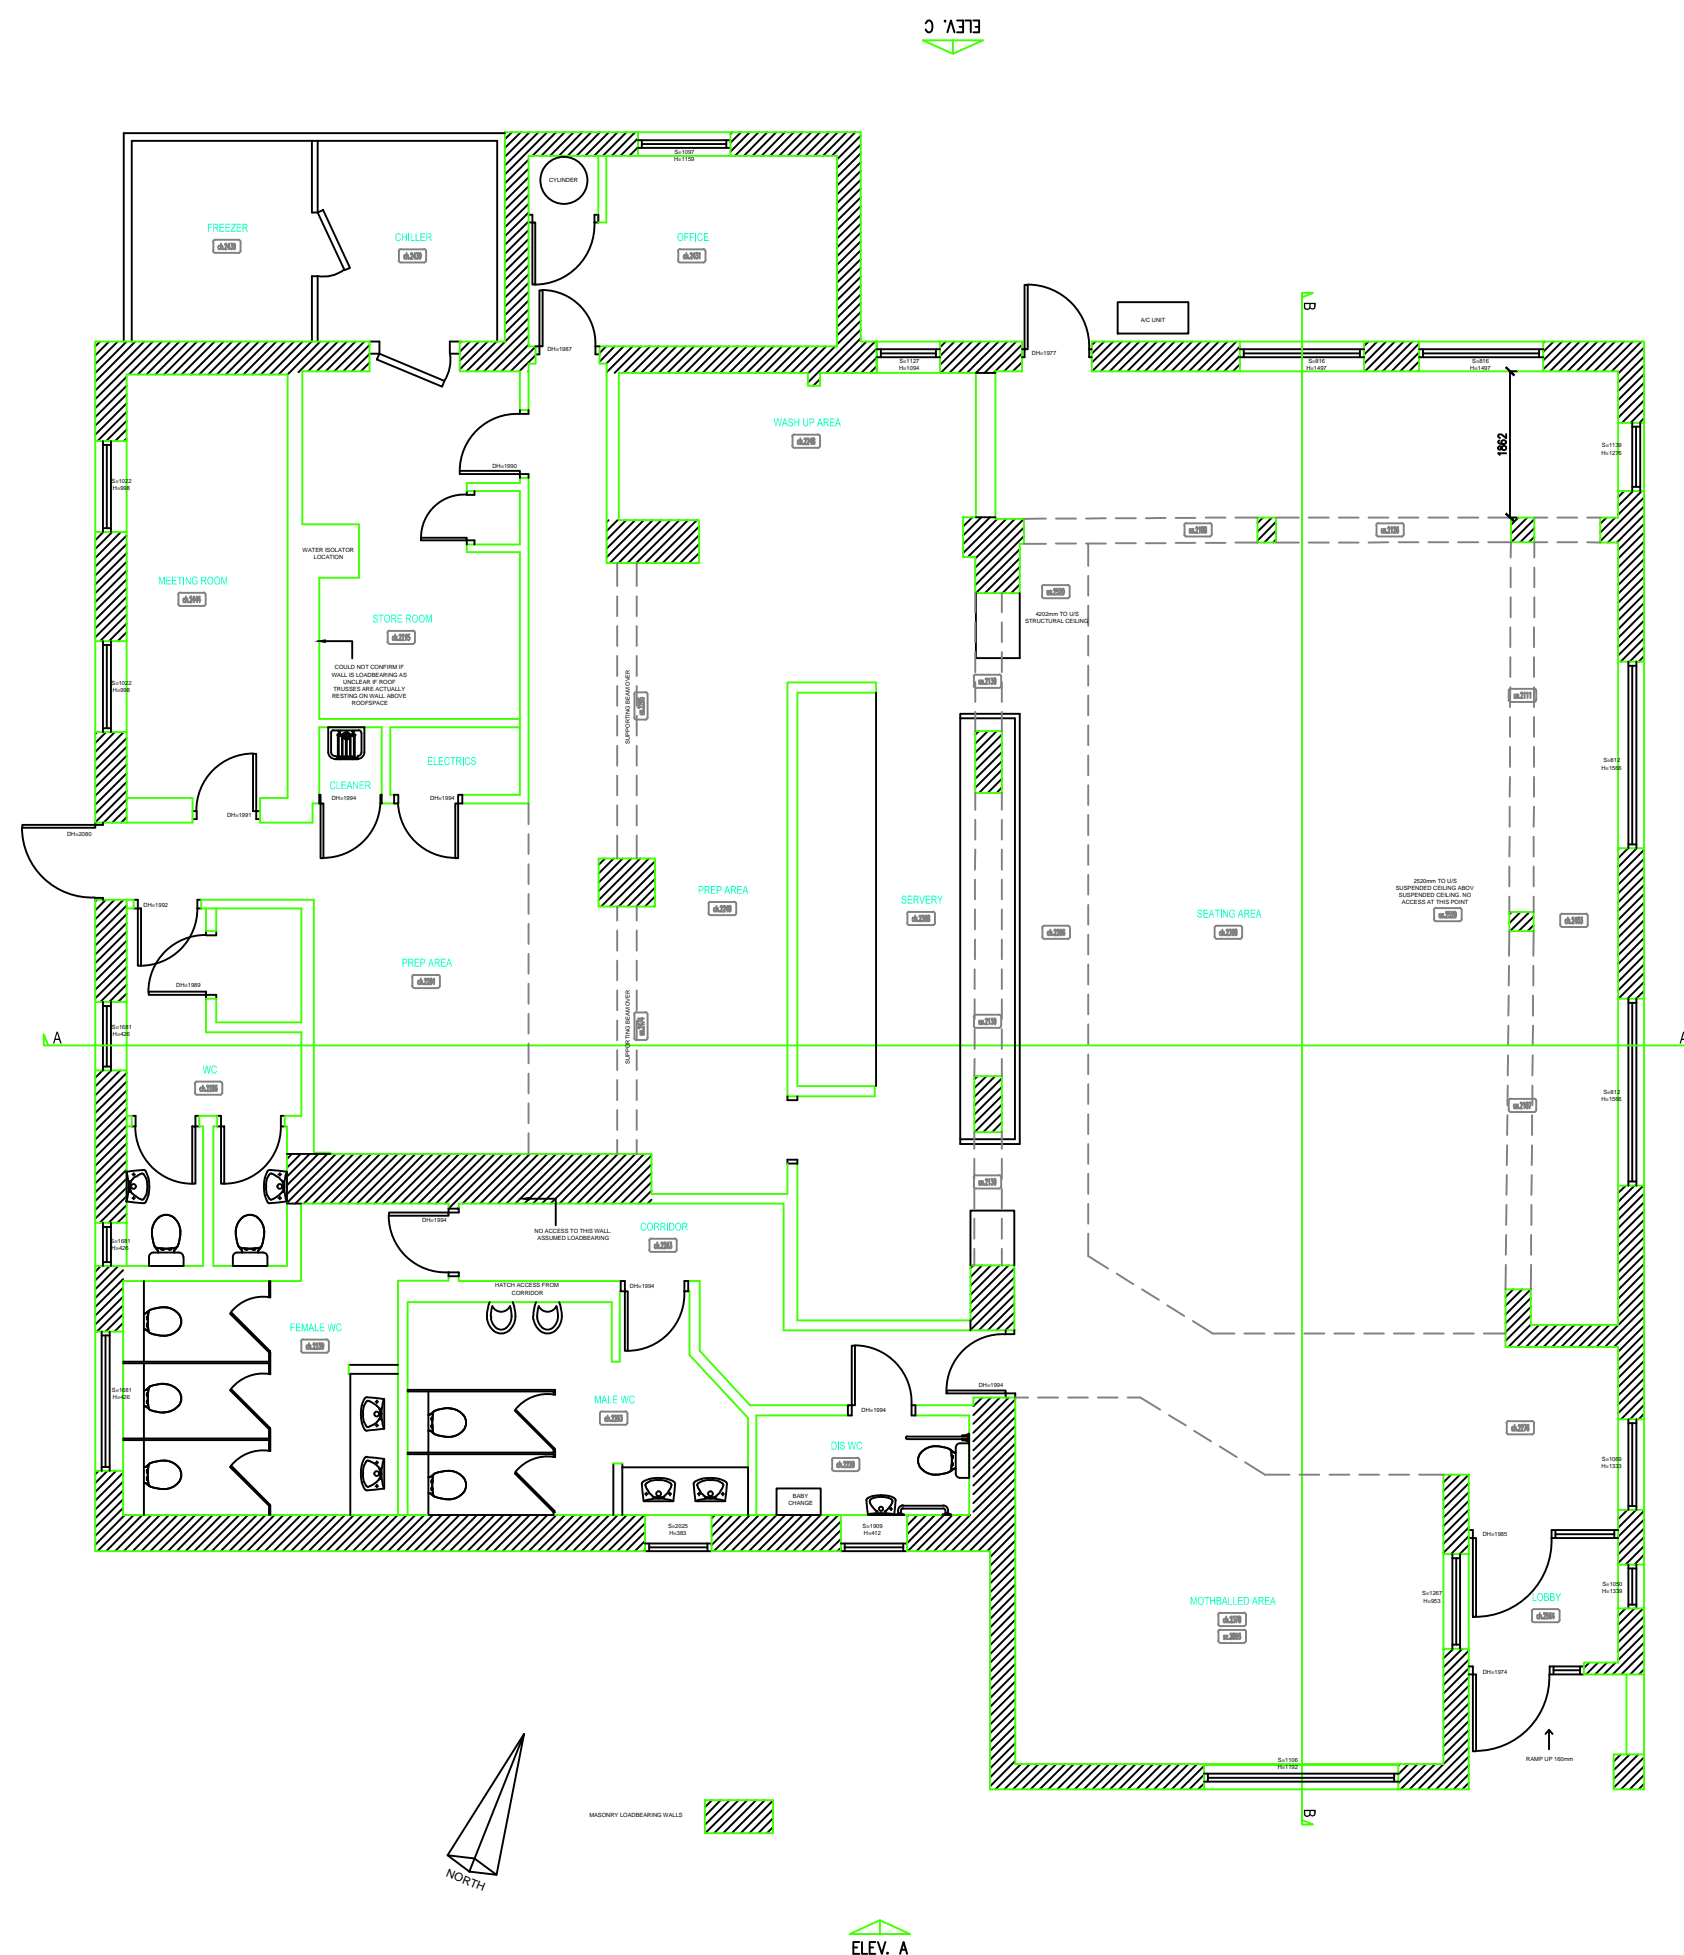


KEY	
	SPRINKLER
	SPEAKER
	SMOKE DETECTOR
	EMERGENCY LIGHT
	WALL MOUNTED CAMERA
	SECURITY CAMERA
	FIRE EXTINGUISHER
	ILLUMINATED FIRE EXIT
	FIRE ROUTE SIGN
	PANIC BREAK POINT
	FIRE ALARM SOUNDER
	AIR VENTILATION INLET
	AIR VENTILATION EXTRACT
	RECESSED SPOT LIGHT
	PENDANT LIGHT

MAJOR SURVEY STAMP

**EVOLVE RPS (LIMITED) SURVEY RETURN (STAMP OF APPROVAL)**  
**SURVEYORS STATEMENT**  
 This survey drawing has been completed by SCOTT KENNEDY, using the dimensions I have recorded from site. This surveying project has been classed as a MAJOR TYPE SURVEY and therefore only check dimensions have been made against the record survey provided. Limited access was made available to inspect concealed areas and therefore a fully intrusive survey should be arranged if additional information is required.  
 SCOTT KENNEDY

**REVIT MODELLERS STATEMENT**  
 This revit model has been completed by RICHARD MERCECA, using the survey information provided by REVIT MODELLERS NAME HERE. I can confirm that I received all information required in order to produce this model and that the model I have produced is an accurate representation of the building.  
 REVIT MODELLERS NAME AGAIN HERE

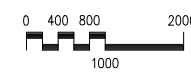

## AS EXISTING SURVEY

REV.	DESCRIPTION	BY	DATE

CLIENT:	
PROJECT:	SKEEBY
ADDRESS:	Little Chef Great North Road Richmond DL10 5EQ
TITLE:	AS EXISTING SURVEYS GROUND FLOOR LAYOUT
DRAWN BY:	SK
CHECKED:	RM
SCALE:	1:100 @A3
DRAWN DATE:	20.12.16
REVISED DATE:	
DRG NO.:	EUROG-SKEEB-001-01
REV:	

THIS DRAWING AND ITS DATA IS THE PROPERTY OF EVOLVE ARCHITECTURE & SHALL NOT BE REPRODUCED WITHOUT THE COMPANY'S CONSENT. DO NOT SCALE. WRITTEN DIMENSIONS TAKE PRECEDENCE. ANY DISCREPANCIES SHOULD BE REPORTED TO EVOLVE ARCHITECTURE IMMEDIATELY - IF IN DOUBT ASK.