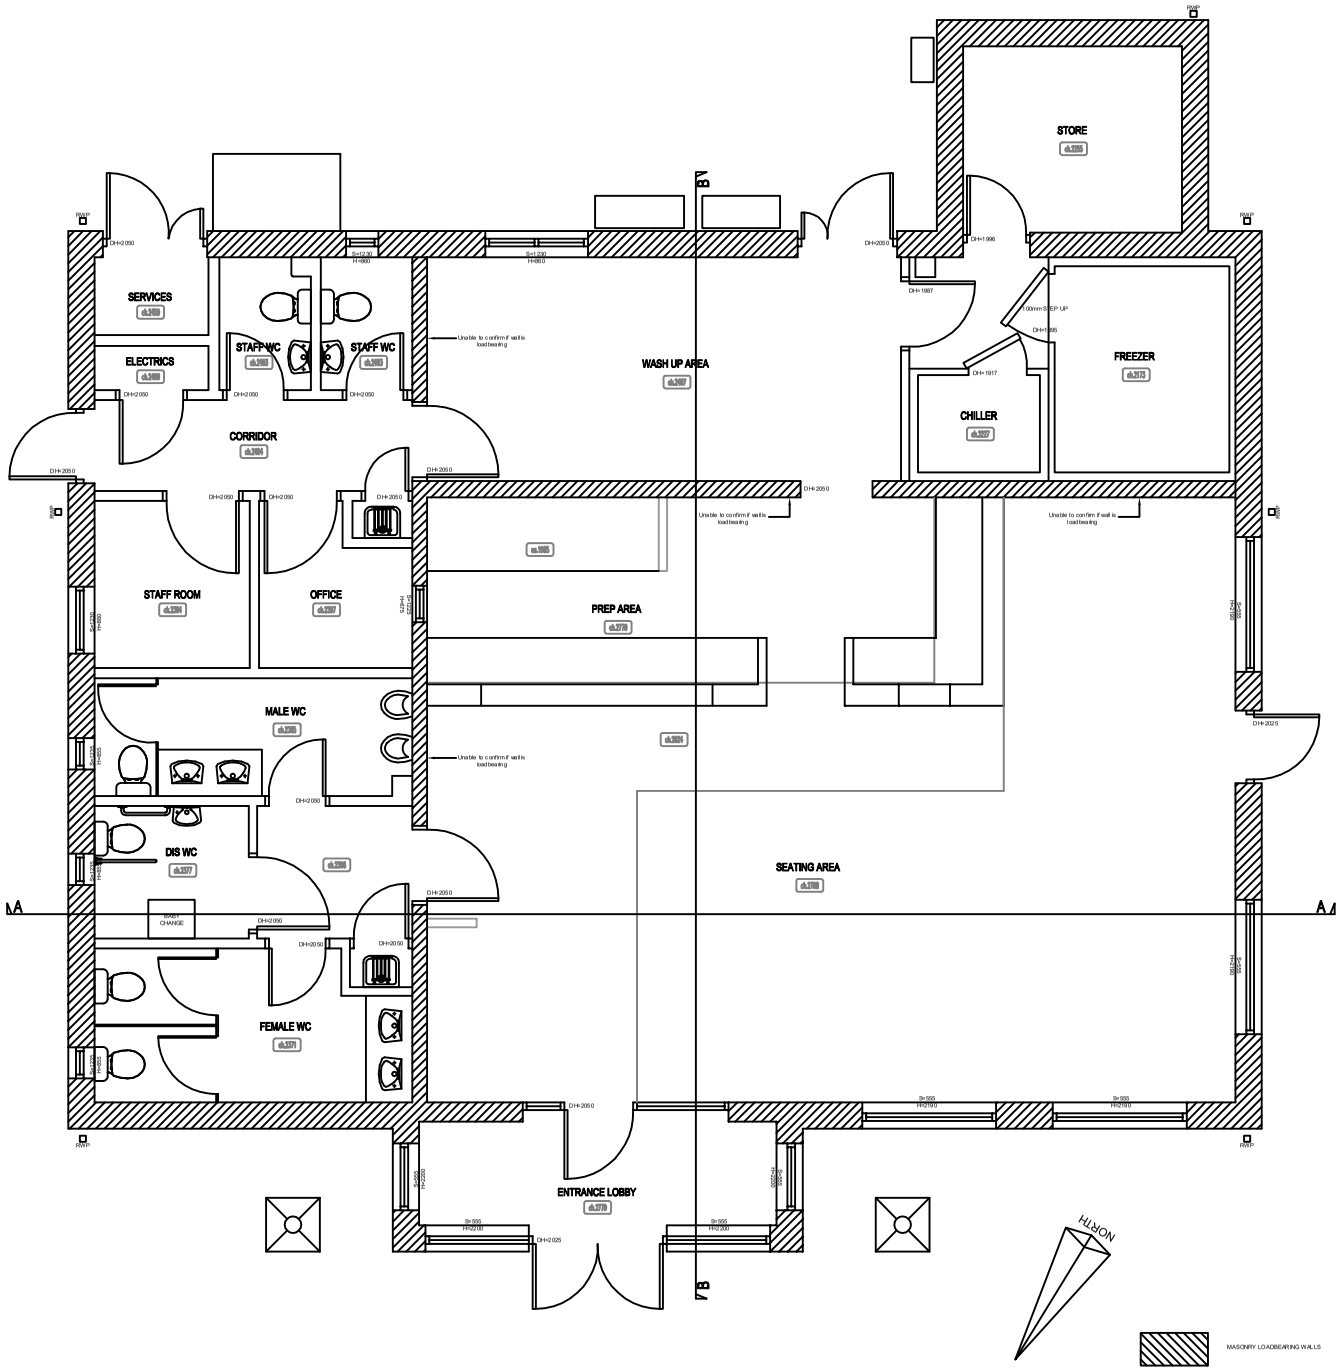

KEY

- SPRINKLER
- SPEAKER
- SMOKE DETECTOR
- EMERGENCY LIGHT
- WALL MOUNTED CAMERA
- SECURITY CAMERA
- FIRE EXTINGUISHER
- ILLUMINATED FIRE EXIT
- FIRE ROUTE SIGN
- PANIC BREAK POINT
- FIRE ALARM SOUNDER
- AIR VENTILATION INLET
- AIR VENTILATION EXTRACT
- RECESSED SPOT LIGHT
- PENDANT LIGHT

MAJOR SURVEY STAMP

EVOLVE RPS (LIMITED) SURVEY RETURN (STAMP OF APPROVAL)

SURVEYORS STATEMENT

this survey drawing has been completed by SCOTT KENNEDY, using the dimensions I have recorded from site. This surveying project has been classed as a MAJOR TYPE SURVEY and therefore only check dimensions have been made against the record survey provided. Limited access was made available to inspect concealed areas and therefore a fully intrusive survey should be arranged if additional information is required

SCOTT KENNEDY

REVIT MODELLERS STATEMENT

this revit model has been completed by RICHARD MERCIECA, using the survey information provided by REVIT MODELLERS NAME HERE. I can confirm that I received all information required in order to produce this model and that the model I have produced is an accurate representation of the building

REVIT MODELLERS NAME AGAIN HERE

0 400 800 2000

1000

SCALE AT 1:100

DRAWING NOTES

Please note: These drawings are for planning purposes only and should not be used for construction.

AS EXISTING SURVEY

REV.	DESCRIPTION	BY	DATE

evolve.

evolve architecture
evolve-architecture.com
T: +44 (0) 1934 822763
F: +44 (0) 1934 822764

CLIENT:

PROJECT: KETTERING EAST

ADDRESS: Little Chef
A14 Ramp
Kettering
NN14 1SS

TITLE: AS EXISTING SURVEYS
GROUND FLOOR LAYOUT
.

DRAWN BY	SCALE	DRAWN DATE	REVISED DATE
SK	1:100 @A3	20.04.17	.
CHECKED BY: RM			

DRG NO: EUROG-KETTE-001-01 REV: .

THIS DRAWING AND ITS DATA IS THE PROPERTY OF EVOLVE ARCHITECTURE & SHALL NOT BE REPRODUCED WITHOUT THE COMPANY'S CONSENT. DO NOT SCALE. WRITTEN DIMENSIONS TAKE PREFERENCE. ANY DISCREPANCIES SHOULD BE REPORTED TO EVOLVE ARCHITECTURE IMMEDIATELY - IF IN DOUBT ASK.